

30 June, 2026

Addendum 1

**Columbus County Transportation
Whiteville, NC**


The following addendum shall supersede previous information and does hereby become part of the contract documents.

- See attached Revised P-2.
- See attached BD-1 for electrical work required for card access. G.C. to prep frame as required for card access to tie into existing system. Card access hardware to be a part of the hardware allowance.
- Clarification: All vinyl cove base to be 4" vinyl cove base (0.125" thick) with prefabricated corners.
- See below for the link to the US Department of Labor for Davis Bacon Wage determinations.

<https://www.dol.gov/agencies/whd/government-contracts/prevaling-wage-resource-book/db-wage-determinations>

- SD-1; Clarification: Existing fence to be moved by owner. Temporary construction fence by G.C.
- SD-1; Existing tree in area of new addition to be removed by G.C.
- Clarification: Existing camera on end of building to be moved by owner to allow new addition. Existing antennae to be removed by G.C. This antenna will not be required to be re-installed.
- Clarification: 5% Bid Bond and 100% performance and payment are required for this project.
- Clarification: Buy American Certification is required to be turned in with bid. See specifications for form. See also certification and restrictions on lobbying, Government-wide Debarment and Suspension. Forms in specifications which are required to be turned in with bids.
- All contractors shall read all federal guidelines and requirements in the specifications.
- Clarification: G.C. will be responsible for applying and paying for all permits.
- Drawing sheet A-1: Disregard note to provide painted non-slip floor in room 004. Existing finishes here are to remain.
- Clarification: Where Room Finish Schedule calls for new floor finishes, the contractor shall be responsible for demolition of existing floor finish and prep for new floor finish.
- Grading is expected to be minor for the addition. Contractor to grade as required for new addition and fine grade surrounding area. Seed all areas disturbed by construction.
- Clarification: Equal PEMB systems will be acceptable.
- Drawing A-4: Disregard note calling for new brick pilaster.
- Night and weekend work will be allowed for exterior and new addition work. Interior work inside the existing building to be during normal business hours.
- Drawing A-1: The note Requiring vending machine to be replaced with smaller vending machine will be by owner.
- Contractor is responsible for all dust protection.
- Clarification, 03300: Concrete testing to be covered by testing allowance indicated in 01020.
- Clarification: LVP to be as per 09660 or equal products.

End of Addendum 1

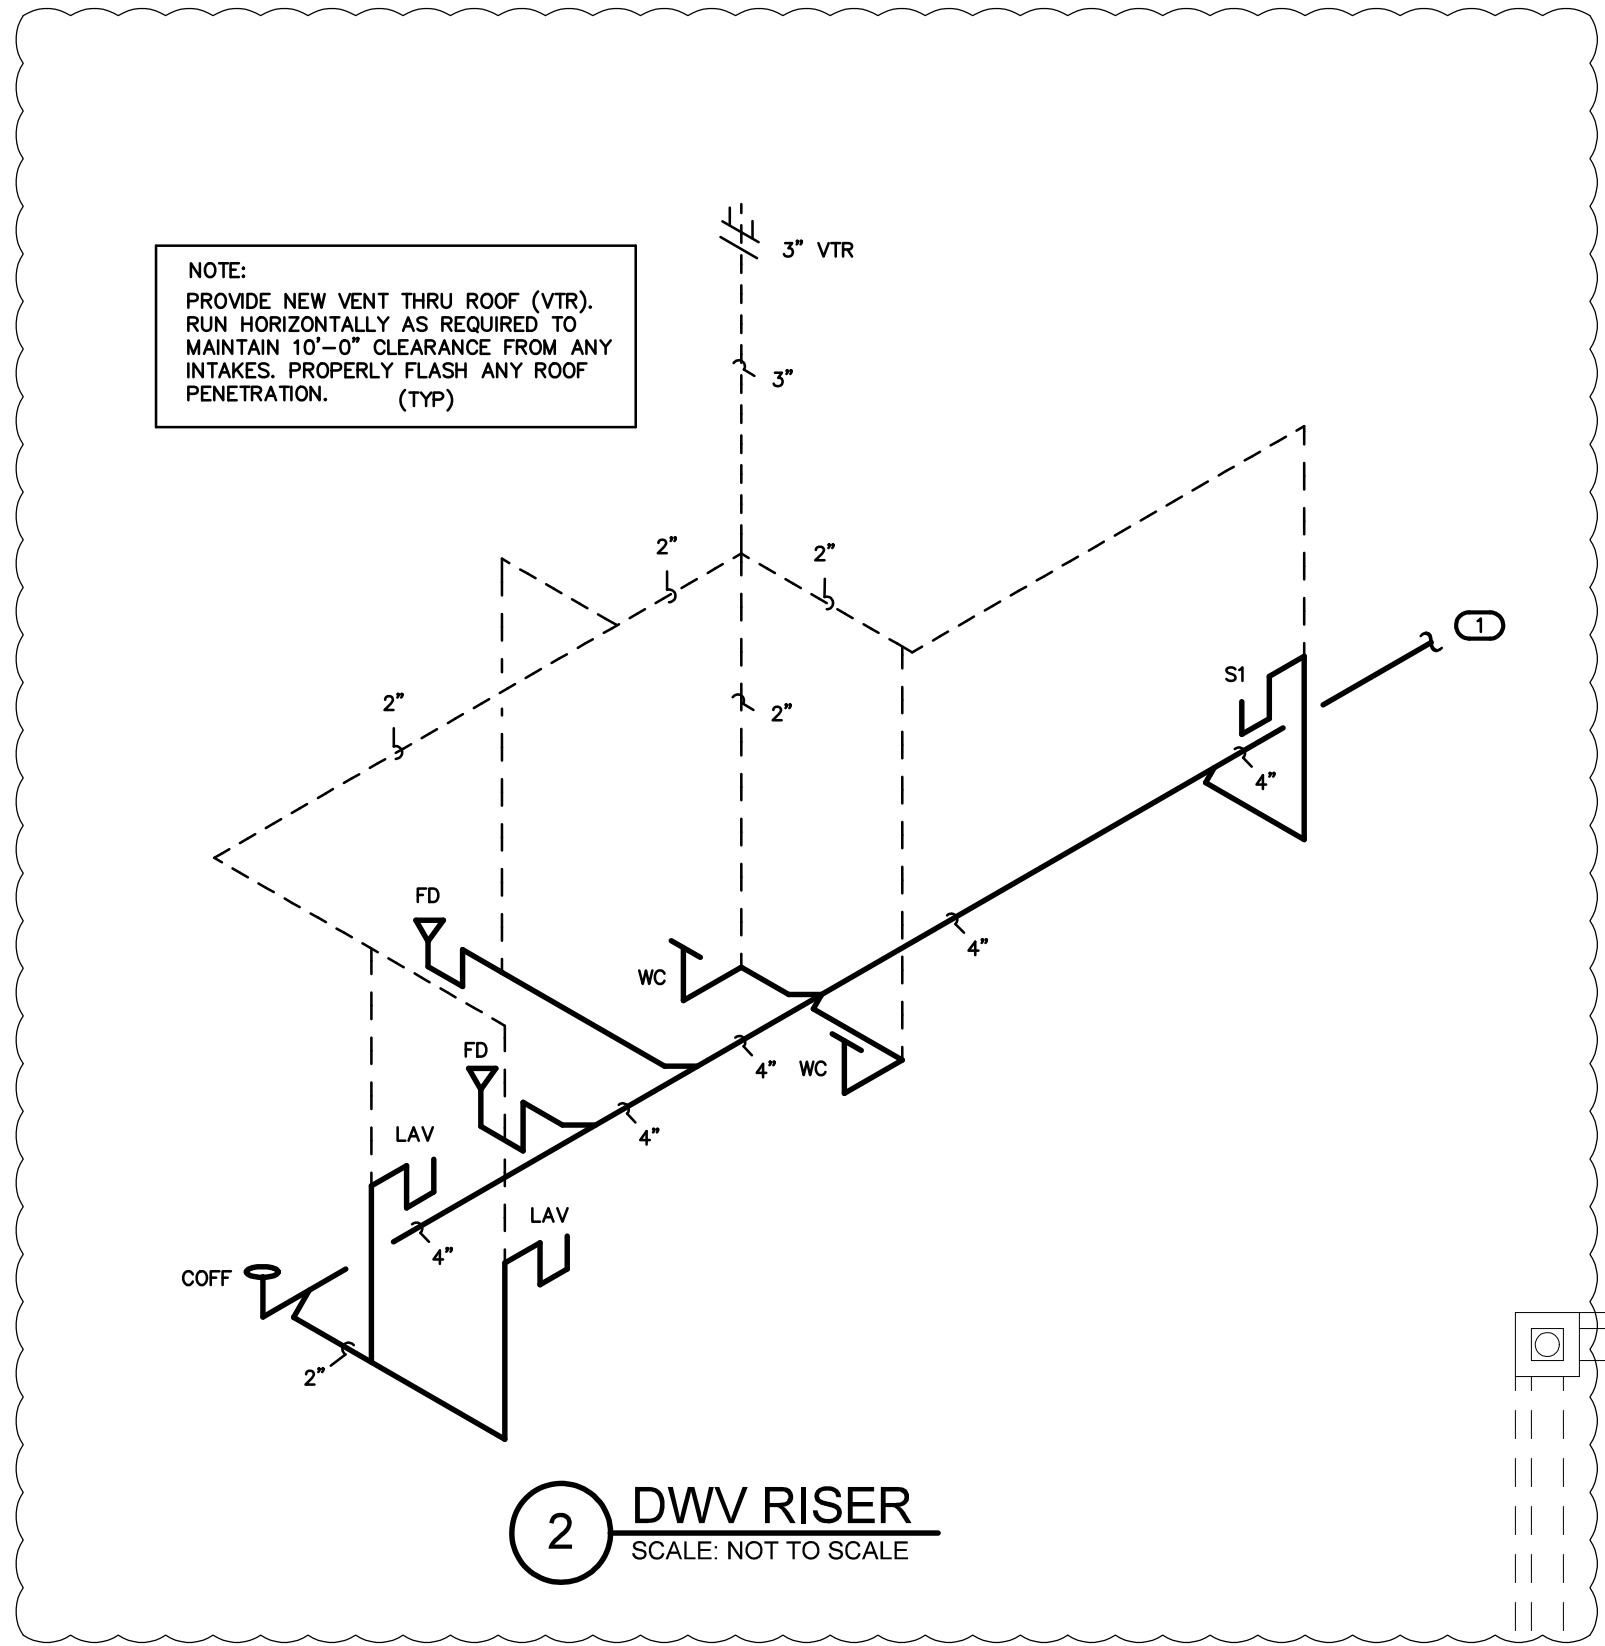

RISER NOTES:
REPRESENTATIVE SIZES ARE GIVEN FOR EACH TYPE OF FIXTURE.
SEE PIPE SIZING SCHEDULE.
MINIMUM 2" DRAIN LINE SIZE UNDER SLAB.
MAINTAIN PIPE SIZES SHOWN UNTIL LARGER SIZE IS REACHED.
PIPE SIZES ARE MINIMUMS FOR INDIVIDUAL FIXTURES U.O.N.

(VERIFY ALL EQUIPMENT REQUIREMENTS PRIOR TO ROUGH-IN)

PIPE SIZING SCHEDULE		
FIXTURE TYPE	DRAIN	VENT
(FD) FLOOR DRAIN	3"	1-1/2"
(LAV) LAVATORY	1-1/2"	1-1/4"
(SI) BREAK ROOM SINK	1-1/2"	1-1/4"
(WC) FLUSH VALVE WATER CLOSET	3"	1 1/2"

NOTE:
ANY EXISTING INFORMATION SHOWN ON THIS SHEET IS FROM PREVIOUS PERMIT DRAWINGS. THE CONTRACTOR IS RESPONSIBLE FOR VISITING THE SITE, FIELD VERIFYING ALL RELEVANT INFORMATION. THE SUBMISSION OF A BID INDICATES ACCEPTANCE OF EXISTING CONDITIONS. NOTIFY THE ENGINEER OF ANY DISCREPANCIES NOTED.


REMOVE AND REPLACE ALL CONCRETE, ASPHALT, WALL MATERIAL, CEILINGS, ETC., AS REQUIRED TO LOCATE EXISTING LINES AND INSTALL NEW LINES.

IT IS THE RESPONSIBILITY OF THE PLUMBING CONTRACTOR TO LOCATE ANY AND ALL EXISTING BUILDING SYSTEMS IN CONCRETE, FLOORS, WALLS, CEILINGS, ETC., PRIOR TO START OF WORK. THAT MAY BE ENCOUNTERED DURING CONSTRUCTION TO DETERMINE METHODS REQUIRED TO AVOID AND/OR MAINTAIN EXISTING SYSTEMS OPERATION. COORDINATE WITH BLDG. OWNER, ARCH., G.C. THE PLUMBING CONTRACTOR SHALL LOCATE, TRACE, AND INSPECT FOR PROPER DRAINAGE AND CONDITION. ANY/ALL EXISTING BUILDING DRAINAGE LINES AND SYSTEMS (SANITARY, GREASE, ETC.) THAT ARE TO BE UTILIZED BY THE OCCUPANT/NEW CONNECTIONS PER DESIGN DRAWINGS THROUGH USE OF CAMERA, DYES, AND/OR ANY MEANS NECESSARY- PRIOR TO THE START OF WORK. THE CONTRACTOR SHALL REMEDY ANY ISSUES IN ORDER TO ENSURE A PROPER FUNCTIONING, CODE COMPLIANT SYSTEM, WHICH INCLUDES BUT IS NOT LIMITED TO, JETTING OF LINES, REMOVAL OF DEBRIS, REPLACEMENT OF ANY IMPROPER OR DAMAGED PIPING. VERIFY AVAILABLE DEPTH/INVERT REQUIREMENTS, FLOW DIRECTION OF EXISTING LINES. PROVIDE DOCUMENTATION TO THE ENGINEER FOR REVIEW. THE EXISTING AND NEW DRAINAGE SYSTEMS/CONNECTIONS SHALL BE TESTED FOR PROPER OPERATION UPON COMPLETION OF WORK. ALL ISSUES AND SOLUTION OPTIONS ARE TO BE COORDINATED WITH THE DRAINAGE SYSTEM/BUILDING OWNER, G.C., ARCHITECT, AND ENGINEER. PROVIDE AS-BUILT DRAWINGS FOR ENGINEER REVIEW.

COORDINATE WORK WITH BUILDING OWNER SO AS NOT TO IMPACT OPERATION OF ANY ADJACENT SPACES/LEVELS. NIGHT AND WEEKEND WORK MAY BE REQUIRED.

KEY NOTES FOR SHEET P2

1 EXTEND TO SEWER MAIN. VERIFY LOCATION, COORDINATE WITH SITE.

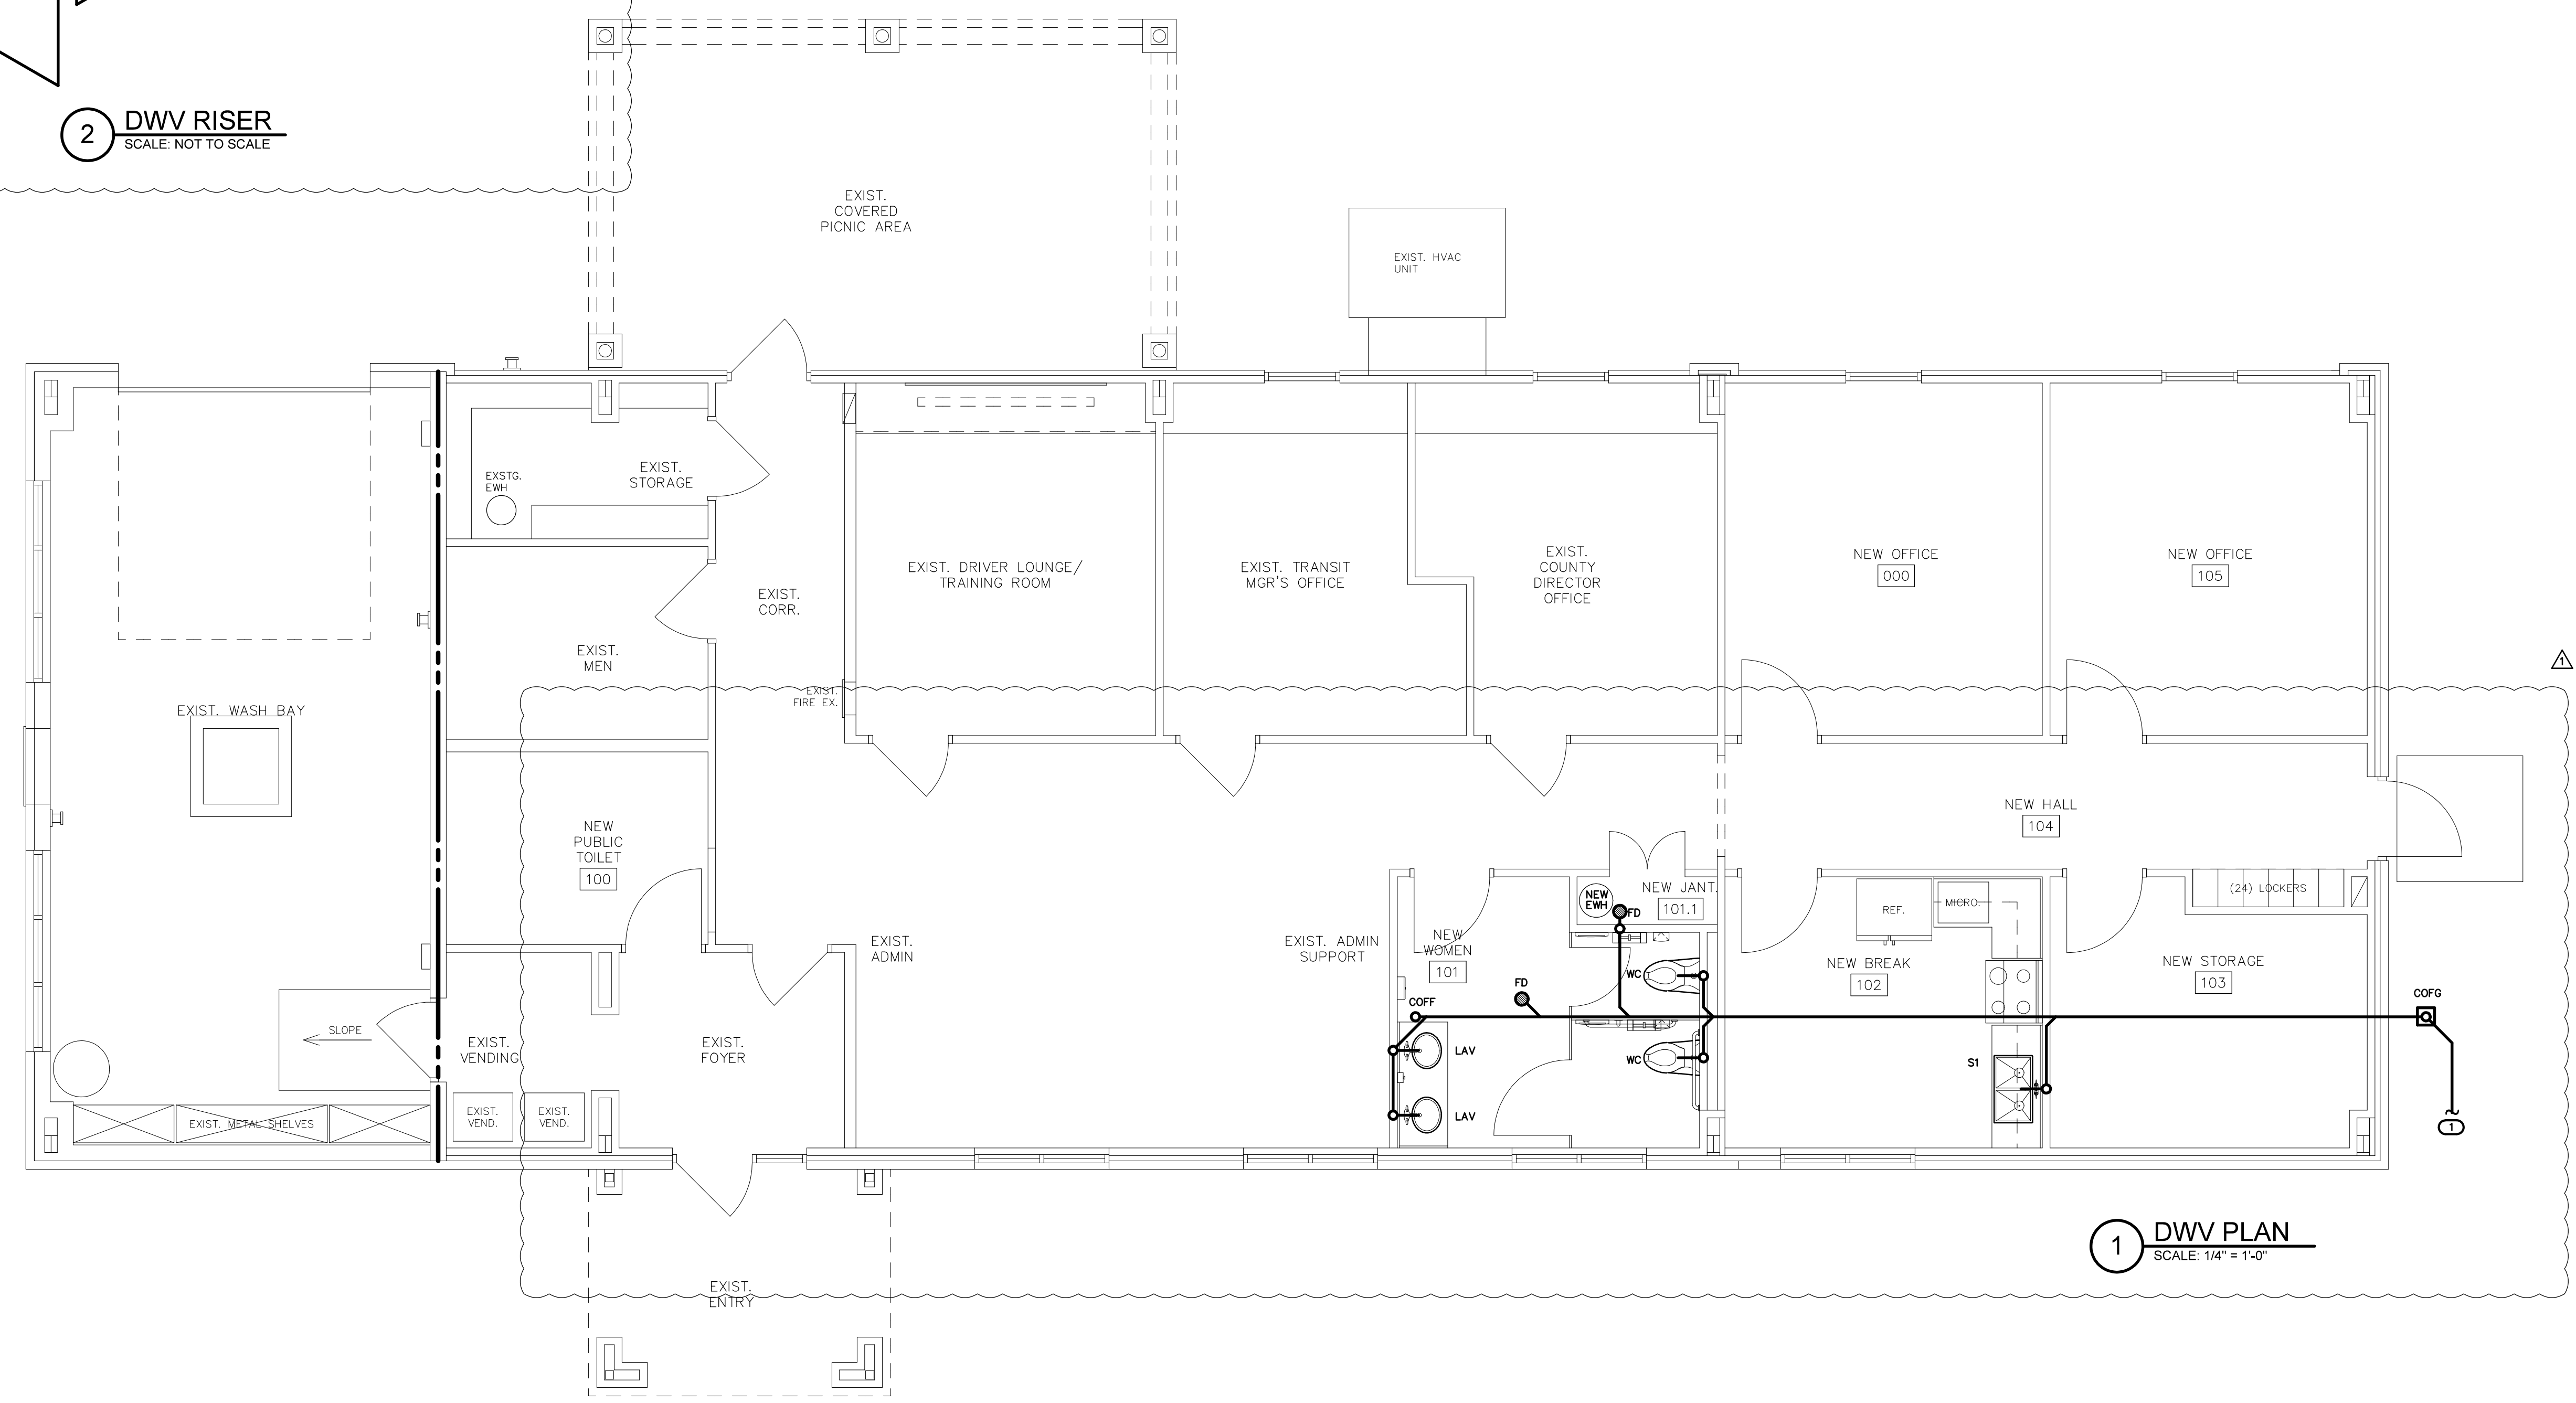

ENGINEER
BURKE DESIGN GROUP
3305-109 DURHAM DRIVE
RALEIGH, NC 27603
PHONE: (919) 771-1916
FAX: (919) 779-0826
email: ben@bdg-nc.com
Corp. License # C-2652

Coastal
Architecture
P.L.L.C.

Architectural
Design
Planning
Interiors


AIA

Member of the American
Institute of Architects

Lee D. Dixon, Jr., AIA
252.947.4127
lee@coastalarchitecture.net

4206 Bridges St. Ext.,
Suite C
Morehead City, NC
28557
www.CoastalArchitecture.net

ADDITION TO COLUMBUS COUNTY
TRANSPORTATION CENTER
WHITEVILLE, NORTH CAROLINA

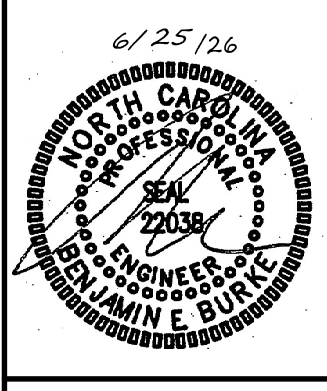

DWG PLAN
AND RISER

25008

ISSUED: 12/09/2025

DWG BY: MRH


CKD BY: BEB

REVISIONS

6/25/26

SHEET NO.



P-2

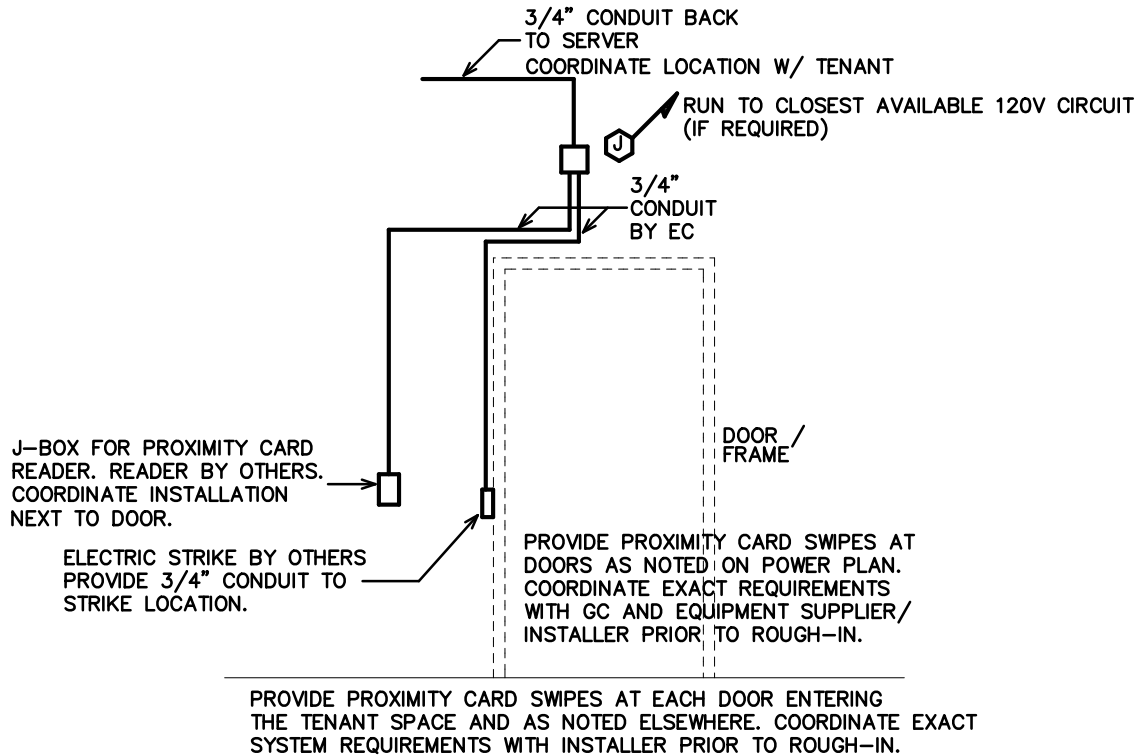

1

2 CARD SWIPE

SCALE: NOT TO SCALE

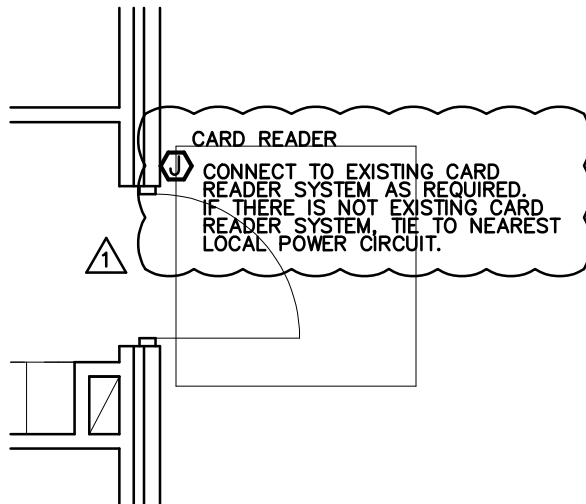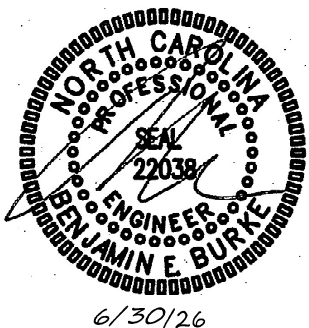

BD-1

DATE 6/30/2026

**COLUMBUS COUNTY
TRANSP. CENTER**

ADDITION
WHITEVILLE, NORTH CAROLINA

**B
D
G**

BURKE DESIGN GROUP, PA

3305-109 DURHAM DRIVE

RALEIGH, NC 27603

PHONE: (919) 771-1916

FAX: (919) 779-0826

email: benburke@nc.rr.com

Corp. License # C-2652